


CONTACT DIG SAFE
72 HOURS PRIOR TO
CONSTRUCTION

NOTES

- 1) UTILITY LOCATION SHOWN ON THESE PLANS ARE APPROXIMATE.
- 2) BEFORE COMMENCEMENT OF ANY UNDERGROUND UTILITY WORK, DIG SAFE SHALL BE NOTIFIED 72 HOURS IN ADVANCE. CALL 1-(888)-DIG-SAFE OR 1-(888)-344-7233.
- 3) ALL TIE LOCATIONS TO BUNCHED WATER SHUT OFF VALVES ARE TO THE RIGHT MOST VALVE.

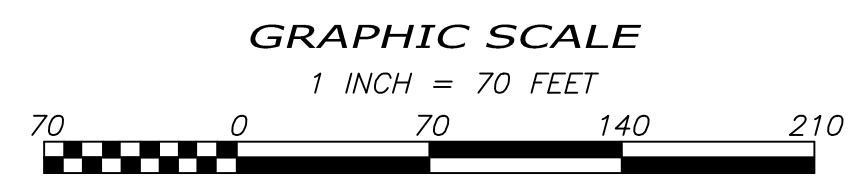

REVISIONS	
	DATE:
	DATE:
CPL	REVISE TIE LOCATIONS DATE: 8/15/12
CPL	INITIAL RELEASE DATE: 7/30/12

AS-BUILT DISTRIBUTION PLAN

HADLEIGH WOODS - EPA ID: 2542160

HADLEIGH WOODS
COMMUNITY WATER SYSTEM
IN
WINDHAM, NEW HAMPSHIRE
AS DRAWN FOR
THE HADLEIGH WOODS
CONDOMINIUM ASSOCIATION
WINDHAM, N.H. 03087

Scale: 1" = 70' Date: JULY, 2012

Prepared by:
LEWIS BUILDERS DEVELOPMENT, INC.
54 SAWYER AVENUE
ATKINSON, N.H. 03811
(803) 362-5333 FAX 362-4936

SHEET # 1